

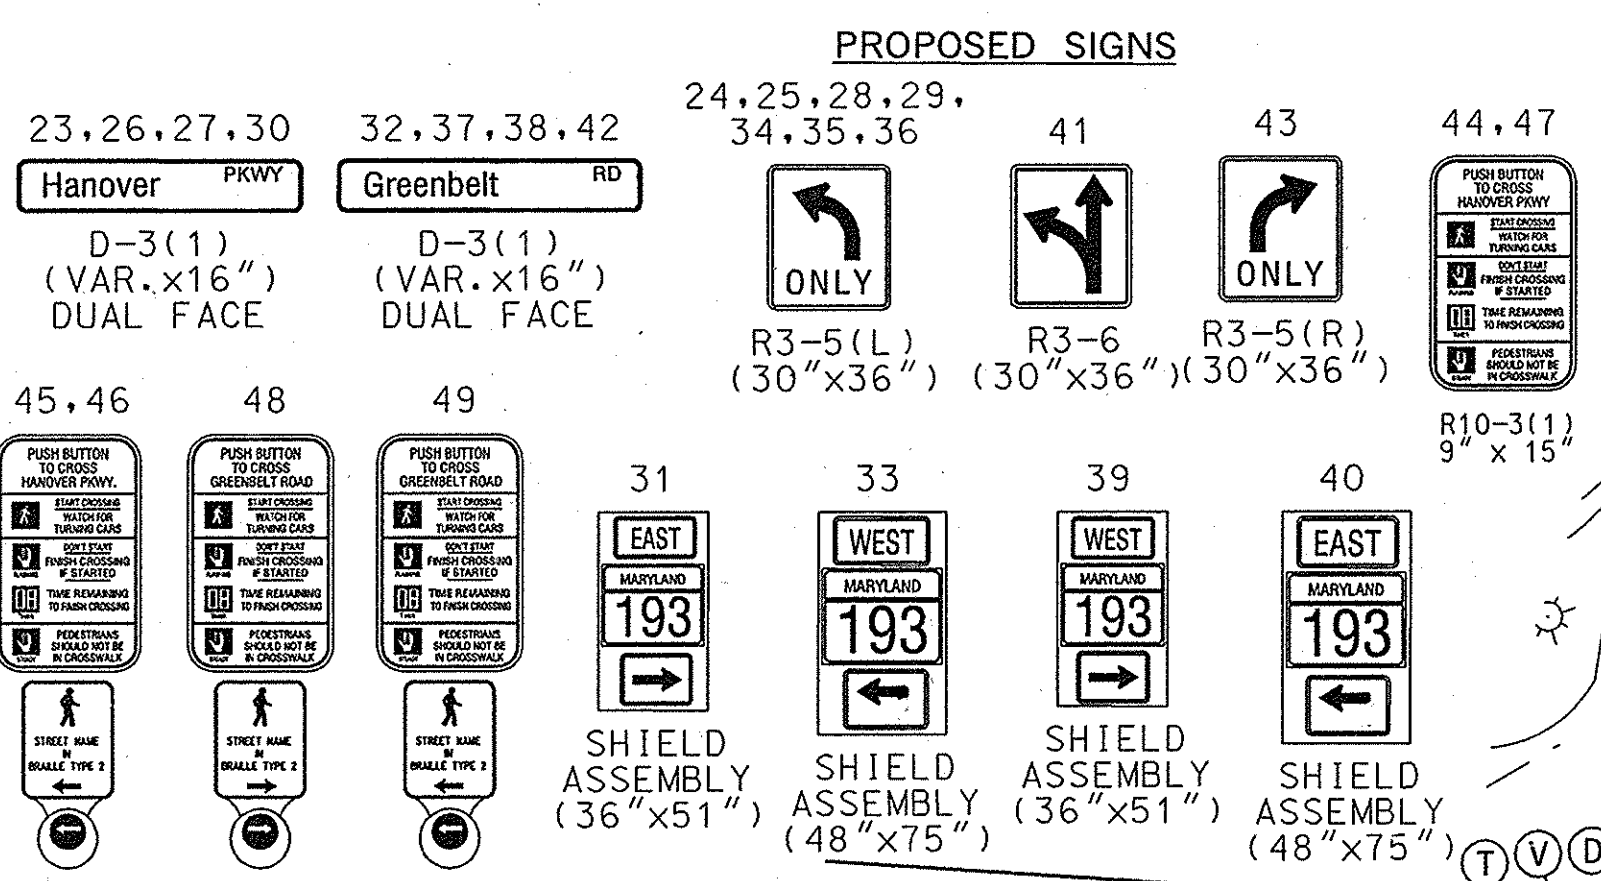


MD 193 IS ASSUMED TO RUN IN AN EAST-WEST DIRECTION


EXISTING SIGNS TO BE REMOVED

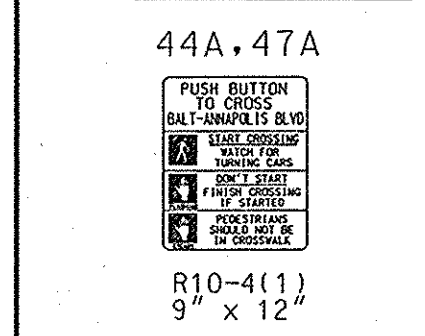


PROPOSED VIDEO DETECTION

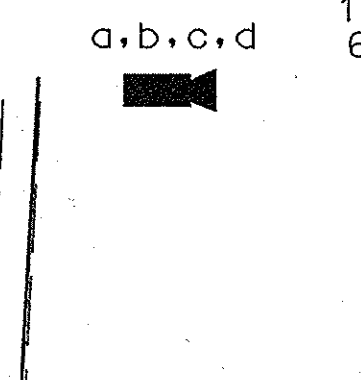


PROPOSED SIGNALS

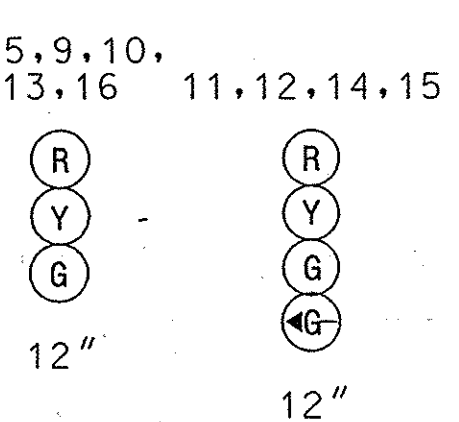

NEMA PHASING

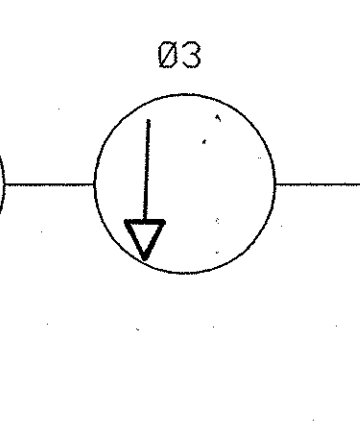

FLASHING OPERATION

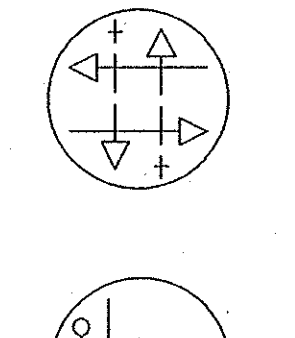

NOTE: PHASES ASSOCIATED BY A DASHED LINE WILL OPERATE CONCURRENTLY. PHASES ASSOCIATED BY A SOLID LINE WILL NOT OPERATE CONCURRENTLY.

CONSTRUCTION DETAILS

- A. INSTALL CONCRETE FOUNDATION WITH A 27 FT. STEEL POLE WITH A 70 FT. MAST ARM, TRAFFIC SIGNAL HEADS, SIGNS, VIDEO DETECTION CAMERA MOUNTED ON MAST ARM AND 15 FT. STREET LIGHTING ARM WITH A 250 WATT HIGH PRESSURE SODIUM VAPOR LUMINAIRE. (INSTALL 1-2 IN. AND 1-4 IN. SCHEDULE 80, 90 DEGREE PVC ELECTRICAL CONDUIT BENDS IN POLE BASE).
- B. INSTALL CONCRETE FOUNDATION WITH A 27 FT. STEEL POLE WITH A 70 FT. MAST ARM, TRAFFIC SIGNAL HEADS, SIGNS, VIDEO DETECTION CAMERA MOUNTED ON MAST ARM AND 15 FT. STREET LIGHTING ARM WITH A 250 WATT HIGH PRESSURE SODIUM VAPOR LUMINAIRE. (INSTALL 1-2 IN. AND 1-4 IN. SCHEDULE 80, 90 DEGREE PVC ELECTRICAL CONDUIT BENDS IN POLE BASE).
- C. INSTALL CONCRETE FOUNDATION WITH A 27 FT. STEEL POLE WITH A 70 FT. MAST ARM, TRAFFIC SIGNAL HEADS, SIGNS, VIDEO DETECTION CAMERA MOUNTED ON MAST ARM AND 15 FT. STREET LIGHTING ARM WITH A 250 WATT HIGH PRESSURE SODIUM VAPOR LUMINAIRE. (INSTALL 1-2 IN. AND 1-4 IN. SCHEDULE 80, 90 DEGREE PVC ELECTRICAL CONDUIT BENDS IN POLE BASE).
- D. INSTALL CONCRETE FOUNDATION WITH A 16.5 FT. (115'-0" T) STEEL POLE WITH A 70 FT. MAST ARM, TRAFFIC SIGNAL HEADS, SIGNS, VIDEO DETECTION CAMERA MOUNTED ON MAST ARM AND 15 FT. STREET LIGHTING ARM WITH A 250 WATT HIGH PRESSURE SODIUM VAPOR LUMINAIRE. (INSTALL 1-2 IN. AND 1-4 IN. SCHEDULE 80, 90 DEGREE PVC ELECTRICAL CONDUIT BENDS IN POLE BASE).
- E. INSTALL CONCRETE FOUNDATION WITH 10 FT. STEEL PEDESTAL POLE WITH BREAKAWAY BASE, COUNTDOWN PEDESTRIAN SIGNAL HEAD, AUDIBLE/TACTILE PEDESTRIAN PUSHBUTTON INSTALLED WITH VIBRATING ARROW POINTING RIGHT, R10-3(1) SIGN. (SIGN TO READ "PUSH BUTTON TO CROSS GREENBELT RD") AND VIDEO DETECTION CAMERA MOUNTED ON MAST ARM. (INSTALL 1-2 IN. AND 1-4 IN. SCHEDULE 80, 90 DEGREE PVC ELECTRICAL CONDUIT BENDS IN POLE BASE).
- F. INSTALL CONCRETE FOUNDATION WITH 10 FT. STEEL PEDESTAL POLE WITH BREAKAWAY BASE, COUNTDOWN PEDESTRIAN SIGNAL HEAD, AUDIBLE/TACTILE PEDESTRIAN PUSHBUTTON INSTALLED WITH VIBRATING ARROW POINTING LEFT, R10-3(1) SIGN. (SIGN TO READ "PUSH BUTTON TO GREENBELT RD"). (INSTALL 1-3 IN. SCHEDULE 80, 90 DEGREE PVC ELECTRICAL CONDUIT BEND IN PEDESTAL BASE).
- G. INSTALL CONCRETE FOUNDATION WITH 10 FT. STEEL PEDESTAL POLE WITH BREAKAWAY BASE, COUNTDOWN PEDESTRIAN SIGNAL HEAD, AUDIBLE/TACTILE PEDESTRIAN PUSHBUTTON INSTALLED WITH VIBRATING ARROW POINTING LEFT, R10-3(1) SIGN. (SIGN TO READ "PUSH BUTTON TO HANOVER PKWY"). (INSTALL 1-3 IN. SCHEDULE 80, 90 DEGREE PVC ELECTRICAL CONDUIT BEND IN PEDESTAL BASE).
- H. PROPOSED 3 IN. CONDUIT INTO PROPOSED CONDUIT BEND. REMOVE EXISTING R10-4(1) SIGN AND INSTALL R10-3(1) SIGN. (SIGN TO READ "PUSH BUTTON TO CROSS HANOVER PKWY").
- I. REMOVE EXISTING BASE MOUNTED METEDED SERVICE PEDESTAL. REMOVE FOUNDATION 12 IN. BELOW GRADE AND BACKFILL.
- J. INSTALL HANDHOLE.
- K. REMOVE 4 IN. PVC SCHEDULE 80 ELECTRICAL CONDUIT - BORED.
- L. INSTALL 2 IN. PVC SCHEDULE 80 ELECTRICAL CONDUIT - TRENCHED.
- M. INSTALL 3 IN. PVC SCHEDULE 80 ELECTRICAL CONDUIT - TRENCHED.
- N. INSTALL 3 IN. PVC SCHEDULE 80 ELECTRICAL CONDUIT - BORED.
- O. INSTALL 4 IN. PVC SCHEDULE 80 ELECTRICAL CONDUIT - TRENCHED.
- P. INSTALL 4 IN. PVC SCHEDULE 80 ELECTRICAL CONDUIT - TRENCHED.
- Q. INSTALL 12 IN. HEAT APPLIED, WHITE PERMANENT PREFORMED THERMOPLASTIC PAVEMENT MARKING FOR CROSSWALKS.
- R. INSTALL 24 IN. HEAT APPLIED, WHITE PERMANENT PREFORMED THERMOPLASTIC PAVEMENT MARKING FOR STOP LINE.
- S. REMOVE EXISTING BASE MOUNTED CABINET AND CONTROLLER. REMOVE FOUNDATION 12 IN. BELOW GRADE AND BACKFILL.
- T. USE EXISTING HANDHOLE.
- U. USE EXISTING CONDUIT.
- V. CAP AND ABANDON EXISTING CONDUIT.
- X. REMOVE EXISTING STRAIN POLE. REMOVE FOUNDATION 12 IN. BELOW GRADE AND BACKFILL.
- Y. REMOVE EXISTING STRAIN POLE, BACK GUY AND CONTROL AND DISTRIBUTION EQUIPMENT. REMOVE FOUNDATION 12 IN. BELOW GRADE AND BACKFILL.
- Z. REMOVE EXISTING SPAN WIRE AND ALL ASSOCIATED EQUIPMENT.
- AA. REMOVE EXISTING PEDESTAL POLE. REMOVE FOUNDATION 12 IN. BELOW GRADE AND BACKFILL.
- BB. REMOVE EXISTING HANDHOLE.
- CC. INSTALL "WEST, MD 193, LEFT ARROW" (48 IN. x 75 IN.) AND "WEST, MD 193, RIGHT ARROW" (36 IN. x 51 IN.) SHIELD ASSEMBLIES ON TWO 4 IN. x 6 IN. TREATED WOOD POST (L=19').
- DD. INSTALL NEMA SIZE 6" BASE MOUNTED CONTROLLER AND CABINET WITH CONCRETE PAD. (INSTALL 2-2 IN. AND 2-4 IN. SCHEDULE 80, 90 DEGREE PVC ELECTRICAL CONDUIT BENDS IN CABINET BASE).
- EE. INSTALL BASE MOUNTED METEDED SERVICE PEDESTAL WITH 2-2 IN. AND 1-4 IN. SCHEDULE 80, 90 DEGREE PVC CONDUIT BENDS IN PEDESTAL BASE.
- FF. INSTALL 3 IN. SCHEDULE 80, POLYVINYL CHLORIDE ELECTRICAL CONDUIT - BORED FOR PROPOSED UNDERGROUND ELECTRICAL SERVICE. CAP AND MARK CONDUITS 2 FT. ABOVE GRADE AT UTILITY POLE FOR USE BY OTHERS.
- GG. INSTALL 2 IN. SCHEDULE 80, PVC ELECTRICAL CONDUIT - TRENCHED FOR PROPOSED UNDERGROUND ELECTRICAL SERVICE.
- HH. INSTALL 2 IN. SCHEDULE 80, PVC ELECTRICAL CONDUIT - BORED FOR PROPOSED UNDERGROUND TELEPHONE SERVICE. CAP AND MARK CONDUITS 2 FT. ABOVE GRADE AT UTILITY POLE FOR USE BY OTHERS.

GENERAL NOTES

- 1. ALL TRAFFIC SIGNAL FOUNDATIONS SHALL BE INSTALLED AT THE FINAL SIDEWALK OR CURB GRADE FOR CLOSED SECTIONS. HIGHEST ROADWAY PROFILE GRADE FOR OPEN SECTIONS, TO MEET CLEARANCES AS SPECIFIED IN MD 816.03, MD 818.01, MD 818.02, MD 818.04. THE CONTRACTOR SHALL VERIFY ULTIMATE GRADES PRIOR TO THE INSTALLATION OF ALL SIGNAL EQUIPMENT.
- 2. THE CONTRACTOR SHALL VERIFY ALL UNDERGROUND UTILITIES PRIOR TO INSTALLING PROPOSED SIGNAL EQUIPMENT. IF ANY UTILITY CONFLICTS SHOULD ARISE THE CONTRACTOR SHALL CONTACT THE PROJECT ENGINEER.
- 3. VIDEO CAMERA LOCATION / ALIGNING SHALL BE COORDINATED WITH THE SHA ENGINEER.
- 4. THE CONTRACTOR SHALL VERIFY ALL PROPOSED POLE AND CABINET LOCATIONS PRIOR TO INSTALLATION.
- 5. ALL EXISTING TRAFFIC SIGNAL EQUIPMENT REMOVED SHALL BECOME THE PROPERTY OF THE SIGNAL CONTRACTOR UPON COMPLETION OF THE NEW SIGNAL.
- 6. ALL PROPOSED LUMINAIRES SHALL BE SUPPLIED WITH A PHOTOCELL.
- 7. THE CONTRACTOR SHALL BE RESPONSIBLE FOR TERMINATING ALL SIGNAL CABLE TO THE APPROPRIATE TERMINALS AND PROPERLY LABEL EACH CABLE.
- 8. REMOVE AND DISPOSE OF ALL UNUSED SIGNAL CABLE.
- 9. THE CONTRACTOR SHALL NOT CUT MAST ARM AS INDICATED ON PLANS UNTIL MAST ARM POLE LOCATION IS FINALIZED.
- 10. PUSHBUTTONS ARE TO BE LOCATED SO THAT THEY CAN BE ACTIVATED BY A PERSON IN A WHEELCHAIR FROM A 60"x60" LEVEL LANDING AREA. A LEVEL LANDING AREA IS AN AREA WITH A CROSS SLOPE OF LESS THAN OR EQUAL TO 2%.
- 11. LOCATION OF ACCESSIBLE PEDESTRIAN SIGNAL PUSHBUTTONS MUST MEET LOCATION REQUIREMENTS OF MUTCD SEC. 4E-09 AND FIG. 4E-02 AND THE LATEST EDITION OF THE MCHRP PUBLICATION, "ACCESSIBLE PEDESTRIAN SIGNALS: GUIDE TO BEST PRACTICE". IF NOT MET, THE CONTRACTOR IS TO STOP WORK UNTIL THE CONFLICT IS RESOLVED. IF NECESSARY, A WAIVER SHALL BE OBTAINED, SIGNED BY THE DIRECTOR, OFFICE OF TRAFFIC AND SAFETY.
- 12. THE CONTRACTOR SHALL DELIVER APS CONTROL UNIT TO SHOP FOR TESTING AND PROGRAMMING.
- 13. FOR FINAL PAVEMENT MARKINGS REFER TO THE PAVEMENT MARKING PLANS, OTHER THAN THOSE DETAILED ON THE PLAN. ALL PAVEMENT MARKINGS SHALL BE INSTALLED IN ACCORDANCE WITH MSHA STANDARDS.
- 14. INSTALL CONDUIT AND LOOP DETECTORS PRIOR TO THE INSTALLATION OF PAVEMENT MARKINGS. REFER TO SIGNING AND PAVEMENT MARKING PLANS FOR ADDITIONAL DETAILS.
- 15. VERIFY PROPOSED GEOMETRIC PRIOR TO INSTALLING SIGNAL EQUIPMENT.
- 16. ALL HANDHOLES SHALL BE INSTALLED AT FINAL GRADE.
- 17. THE SIGNAL CONTRACTOR SHALL DETERMINE IF ANY WORK BY OTHER CONTRACTORS CAN NOT BE COMPLETED UNTIL INSTALLATION OF SIGNAL EQUIPMENT IS COMPLETE. THE SIGNAL CONTRACTOR SHALL NOTIFY OTHER CONTRACTORS OF THIS WORK.
- 18. REFER TO SHEET TSP-2 FOR UTILITY HEIGHTS AND DIMENSIONS OF SIGNAL EQUIPMENT AND PAVEMENT MARKINGS WITHIN INTERSECTION.

SPECIAL NOTES:

- 1. THE CONTRACTOR SHALL NOT BLOCK VIEW OF EXISTING SIGNAL INDICATIONS DURING INSTALLATION OF MAST ARM. IF NEW MAST ARM CANNOT BE INSTALLED DUE TO CONFLICT WITH EXISTING SIGNAL INDICATIONS OR SPAN WIRES, A SIGNAL OUTAGE SHALL OCCUR DURING NON-PEAK HOURS AS DIRECTED BY THE ENGINEER.
- 2. THE TACTILE ARROWS FOR THE AUDIBLE/TACTILE PEDESTRIAN PUSHBUTTONS SHALL BE LOCATED PARALLEL TO THE CROSSWALK FOR WHICH THEY APPLY.
- 3. THE CONTRACTOR SHALL COORDINATE WITH SHA TRAFFIC OPERATION DIVISION TO CONTACT LOCAL POWER COMPANY TO SET-UP WORK WITH TO DISCONNECT THE EXISTING ELECTRICAL SERVICE AND HAVE THE NEW SERVICE ENERGIZED.

WR&A
Whitman, Reardon and Associates, LLP
Engineers, Architects and Planners
801 South Caroline Street
Baltimore, Maryland 21231
410-235-3450

APPROVALS	
TEAM LEADER	ASST. DIR. CHIEF
ASST. DIR. CHIEF	DIVISION CHIEF
DIVISION CHIEF	OFFICE DIRECTOR

REVISIONS	
①	REBUILD TRAFFIC SIGNAL DUE TO GEOMETRIC IMPROVEMENTS SHA, NO. PG679821 5/10/2006
②	SRB NML CS MD 193 PKWY K INSTALL APS AND COUNTDOWN PEDESTRIAN SIGNALS 10/2006
③	CS MD 193 PKWY H ASBUILT FOR RED LIGHT CAMERA INSTALLATION 8/28/2001
FJH	

TRAFFIC SIGNALIZATION PLAN			
SCALE	1" = 20'	DATE	10/1990
DESIGNED BY	J.D.S.	COUNTY	Prince Georges
DRAWN BY	A.B.S.	LOGMILE	16019307.29
CHECKED BY	D.G.M.	TIMS NO.	I-284
FAP NO.	SEE TITLE SHEET	TOD NO.	
TS NO. 1797-L	DRAWING TSP-1 - 1 OF 6	SHEET NO.	OF

PLOTTED: 05-11-2007
FILE: n:\31556-092\csd\p\SG-P001_M193.dgn